


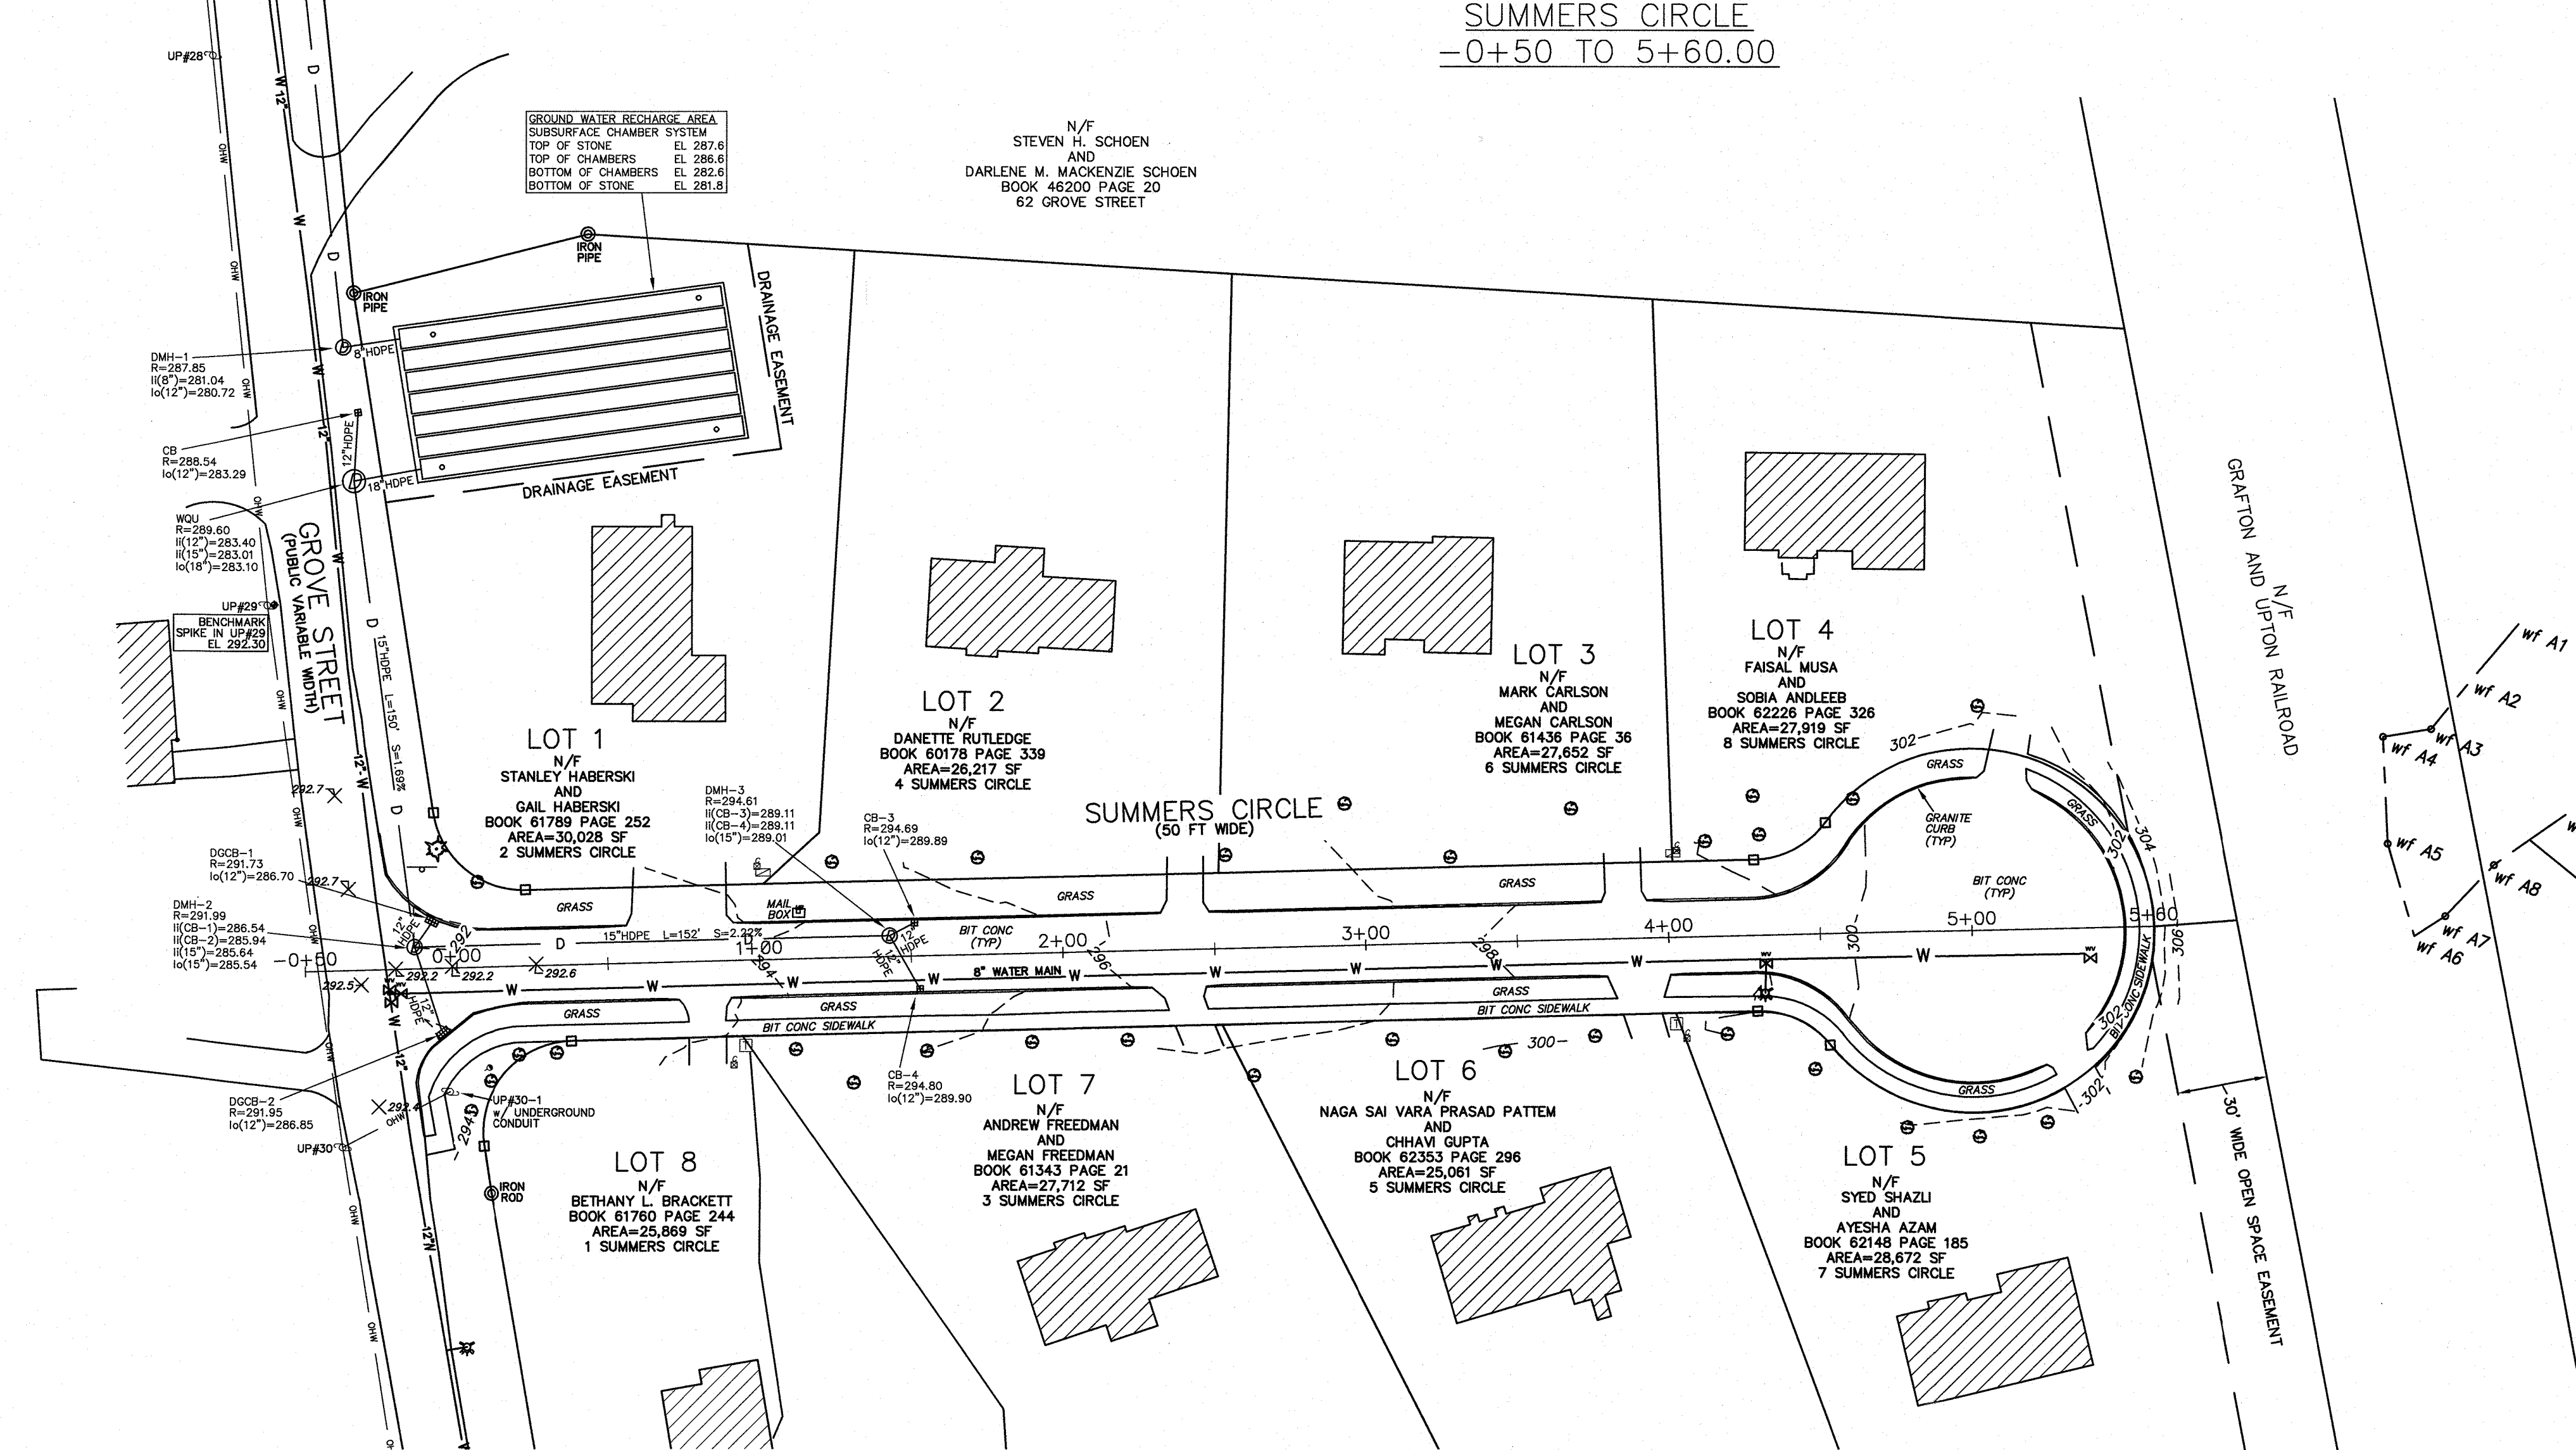

RIGHT OF WAY BOUND SET
ELEVATION CONTOUR
SPOT ELEVATION
DRAIN LINE
DRAIN MANHOLE
WATER QUALITY UNIT
CATCH BASIN
DOUBLE-GRATE CATCH BASIN
WATER LINE
WATER HYDRANT
WATER GATE VALVE
UTILITY POLE
GUY WIRE
OVERHEAD WIRE
ELECTRIC TRANSFORMER
ELECTRIC HANDHOLE
CABLE JUNCTION BOX
SIGN
STREET TREE
BITUMINOUS CONCRETE
HIGH DENSITY POLYETHYLENE
INVERT ELEVATION — IN
INVERT ELEVATION — OUT
NOW OR FORMERLY
RIM ELEVATION
SQUARE FEET

DATE:	DATE: 1-18-22
NOTES	
1) SEE THE FOLLOWING PLANS RECORDED AT THE WORCESTER DISTRICT REGISTRY OF DEEDS--	
PLAN BOOK 924 PLAN 58 JANUARY 2017	
PLAN BOOK 897 PLAN 51 NOVEMBER 2012	
PLAN BOOK 869 PLAN 49 JULY 2008	
PLAN BOOK 788 PLAN 46 NOVEMBER 2002	
PLAN BOOK 772 PLAN 102 OCTOBER 2001	
PLAN BOOK 725 PLAN 105 FEBRUARY 2000	
PLAN BOOK 725 PLAN 15 SEPTEMBER 1998	
PLAN BOOK 694 PLAN 93 JULY 1995	
2) THIS PLAN REFERS TO UPTON TAX MAP 25.	
3) VERTICAL DATUM REFERS TO A PLAN BY BRUCE SALUK & ASSOCIATES, INC. ENTITLED: DEFINITIVE SUBDIVISION PLAN OF WHITNEY FARMS AT COTTON GIN CIRCLE GROVE STREET UPTON, MA	


OWNER
GROVE UPTON DEVELOPMENT, LLC 120 QUARRY DRIVE MILFORD, MA 01757
BOOK 50769 PAGE 376 WORCESTER DISTRICT REGISTRY OF DEEDS

AS BUILT
PLAN AND PROFILE

**SUMMERS CIRCLE
UPTON, MASS.**

SCALE: 1"=40' HORIZONTAL
1"=4' VERTICAL

DATE: JANUARY 14, 2022

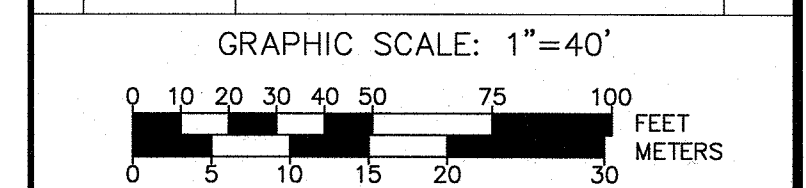[illegible]

**Guerriere &
Halnon, Inc.**

ENGINEERING & LAND SURVEYING

333 WEST STREET PH. (508) 473-6630
MILFORD, MA 01757 FX. (508) 473-8243

www.gandhenengineering.com

SHEET	1 OF 1	G-9902
-------	--------	--------